


PATTERN LEGEND

SYMBOL	DESCRIPTION
	AREA OF MASONRY RESTORATION AND REPOINTING
	AREA OF STONE REMOVAL ADDITIONAL WORK AND RESTORATION

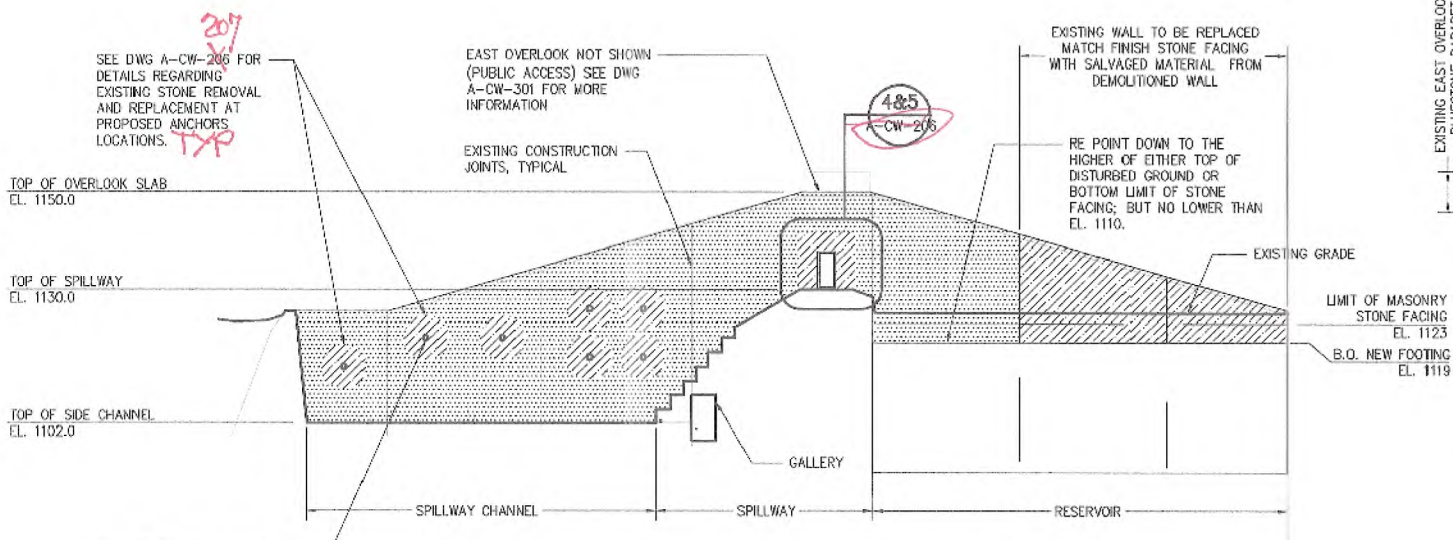

EXISTING EAST OVERLOOK PARAPET DEMOLITION


DETAIL 2

If this isn't in spec add here "Photograph each area & key to plan/elevations"

NOTES:

- SEE A-CW-206 FOR REPOINTING DETAILS.
- REPOINTING:
 - ALL REASONABLE EFFORTS ARE TO BE MADE TO PREVENT REMOVED GROUTING, AND OTHER CONSTRUCTION DEBRIS FROM FALLING INTO RESERVOIR. COLLECT & DISPOSE OF DEBRIS ONLY IN APPROVED AREAS.
 - REPOINT JOINTS OF MASONRY AS DETAILED IN SPECIFICATION SECTION 04901.
- REMOVAL & REPLACEMENT OF STONE BLOCKS FOR ROCK ANCHOR FACING:
 - AREA OF STONES TO BE REMOVED AS INDICATED ON DETAIL 7/A-CW-207.
 - STONES ARE TO BE REMOVED AS WHOLE UNITS. NO CUTTING OR MODIFYING OF STONES.
 - ALL STONES BEING REMOVED ARE TO BE DOCUMENTED AS TO THEIR POSITION ON THE WALL IN ORDER TO REPLACE THEM IN THE SAME LOCATION.
 - REMOVED STONES ARE TO BE CLEANED IS SPECIFIED IN SPECIFICATION SECTION 04910 - MASONRY CLEANING AND RESTORATION; STONES TO BE REUSED ONCE NEW ROCK ANCHORS HAVE BEEN INSTALLED.
 - CONTRACTOR'S STRUCTURAL ENGINEER TO SURVEY AREA OF STONE REMOVAL AND DETERMINE IF TEMPORARY SHORING AND BRACING OF THE SURROUNDING STONE IS REQUIRED.
 - IF SHORING IS TO BE REQUIRED, CONTRACTOR'S STRUCTURAL ENGINEER TO SUBMIT DRAWINGS FOR REVIEW.
 - UPON COMPLETION OF ROCK ANCHOR WORK, STONE BLOCKS ARE TO BE REPOSITIONED ON WALL IN ACCORDANCE WITH THEIR ORIGINAL POSITION AS DOCUMENTED.
 - DUE TO CONCRETE COVERAGE OF ROCK ANCHORS, IT MAY BE NECESSARY TO ALTER THE DEPTH OF THE STONE TO ENSURE ACCURATE FIT AND FACE ALIGNMENT.
 - STONES ARE TO BE FIELD MEASURED INDIVIDUALLY FOR FIT.
 - STONES ARE TO BE ALTERED BY QUALIFIED STONE MASON WITH A MINIMUM OF COPY NOTE.
 - ANCHOR MOUNTS ARE TO BE USED TO SECURE RESET STONES TO CONCRETE FACE; SEE MASONRY ANCHOR DETAIL ON DRAWING S-CG-148 FOR DETAILS.
- REMOVAL & REPLACEMENT OF STONES BLOCKS FOR NEW EAST WALL EXPANSION JOINT:
 - REMOVE STONES IN WHOLE UNITS ALONG VERTICAL LINE OF NEW EXPANSION JOINT AS INDICATED ON DETAIL 5/A-CW-206.
 - CONTRACTOR'S STRUCTURAL ENGINEER TO SURVEY AREA OF STONE REMOVAL AND DETERMINE IF TEMPORARY SHORING AND BRACING OF THE SURROUNDING STONE IS REQUIRED.
 - IF SHORING IS TO BE REQUIRED, CONTRACTOR'S STRUCTURAL ENGINEER TO SUBMIT DRAWINGS FOR REVIEW.
 - REMOVED STONES ARE TO BE CLEANED IS SPECIFIED IN SPECIFICATION SECTION 04910 - MASONRY CLEANING AND RESTORATION.
 - REMOVED STONES ARE TO BE CUT SO THAT WHEN THEY ARE RESET THE CUT ALIGNS (IS PARALLEL) WITH NEW EXPANSION JOINT.
 - SEE SPECIFICATION SECTION 04051 FOR MORTAR TYPE TO BE USED.
 - ANCHOR MOUNTS ARE TO BE USED TO SECURE RESET STONES TO CONCRETE FACE; SEE MASONRY ANCHOR DETAIL ON DRAWING S-CG-148 FOR DETAILS.
- DEP SECURITY FENCE NOT SHOWN.

General Note. Details called out are 2, 4, & 6? shouldnt this be 1, 2, & 3?

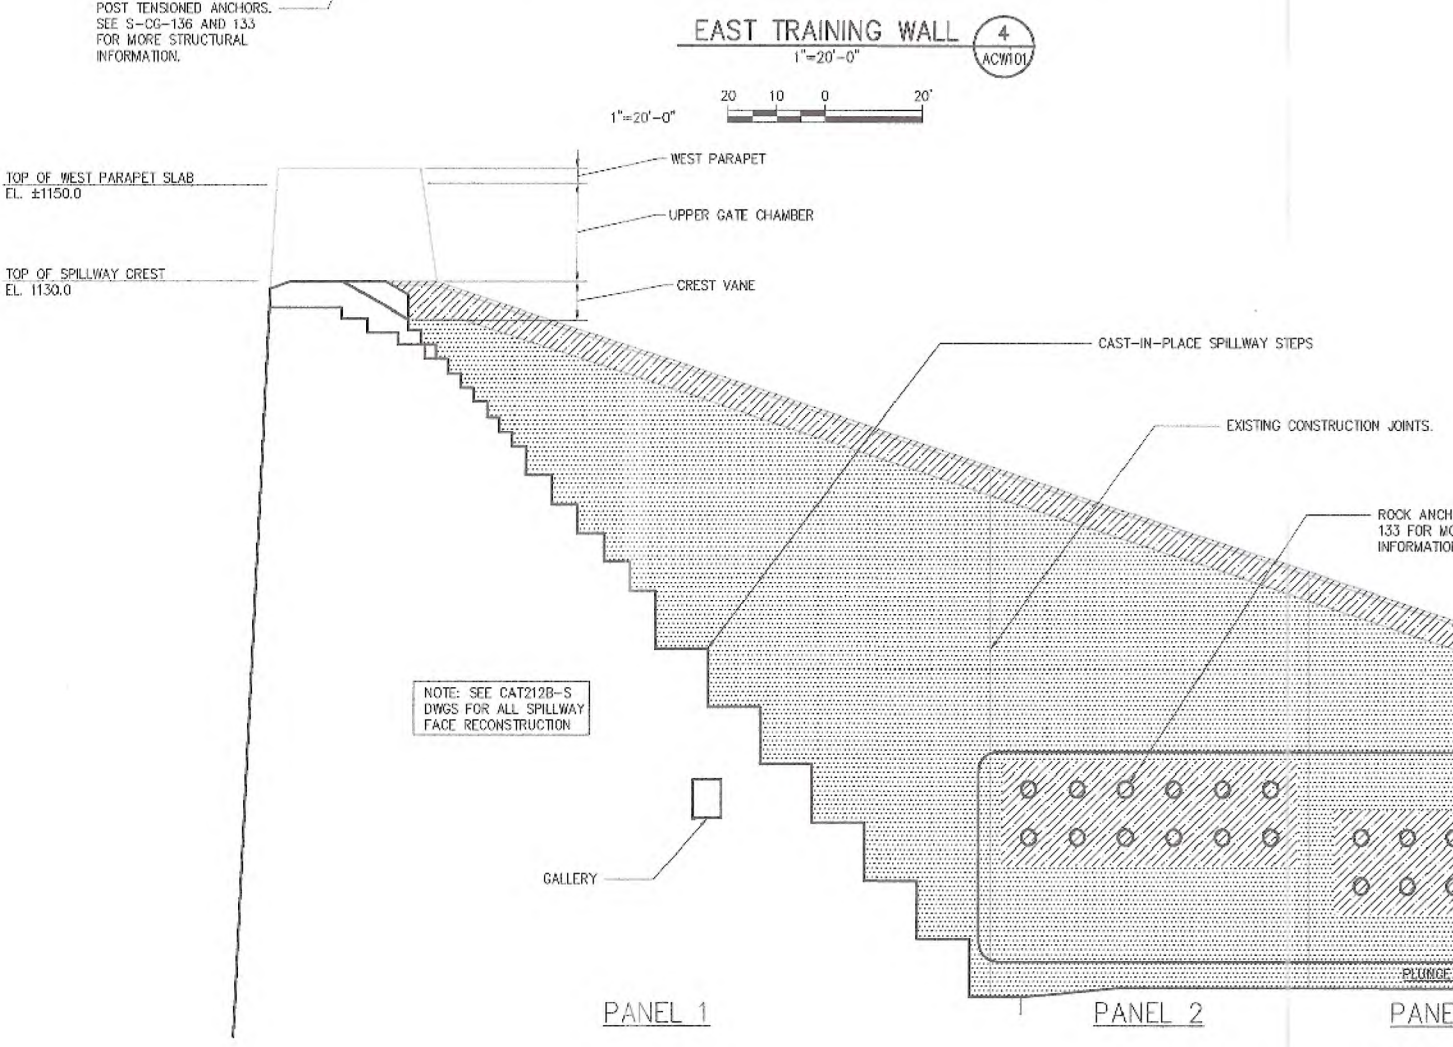

WEST TRAINING WALL 6

SCALE 1"=20'-0"

GoshowArchitects
44 West 28th Street, 5 Fl / New York, NY 10001
P 212.242.3735 / F 212.242.7460

GENERAL CONSTRUCTION NOTE:
SEE CIVIL AND STRUCTURAL DRAWINGS FOR COMPLETE SCOPE OF WORK.

<p>WARNING: THIS IS A PRELIMINARY DRAWING. IT IS NOT TO BE USED FOR CONSTRUCTION OR FOR ANY OTHER PURPOSE WITHOUT THE WRITTEN PERMISSION OF THE ARCHITECT. THE ARCHITECT'S OFFICE SHALL NOT BE RESPONSIBLE FOR ANY ERRORS OR OMISSIONS IN THIS DRAWING.</p>		<p>DESIGNED: KT DRAWN: AM CHECKED: MR SECT. CHIEF: FEG PROJ. ENGR: JC</p>	<p>SCALE: AS SHOWN</p>	<p>Gannett Fleming HAZEN AND SAWYER A Joint Venture 488 Seventh Avenue - New York, NY 10018 212.777-3000 Fax: 212.514-3016</p>	<p>APPROVED FOR THE CITY OF NEW YORK EXECUTIVE PROJECT MANAGER P.E. CHIEF, UPSTATE WATER SUPPLY TREATMENT & FACILITIES DIVISION P.E.</p>	<p>NEW YORK CITY DEPARTMENT OF ENVIRONMENTAL PROTECTION DEP CITY OF NEW YORK DEPARTMENT OF ENVIRONMENTAL PROTECTION BUREAU OF ENGINEERING DESIGN & CONSTRUCTION WM-30 WATERSHED IMPROVEMENTS RECONSTRUCTION OF CATSKILL WATERSHED DAMS AND ASSOCIATED FACILITIES</p>	<p>GILBOA DAM AND ASSOCIATED FACILITIES RECONSTRUCTION CONTRACT CAT-212B ARCHITECTURAL MASONRY RESTORATION-TRAINING WALLS - SHEET 2 OF 2</p>	<p>90% SUBMITTAL DATE: AUGUST 2009 SHEET NO: A10 OF DWG NO: A-CW-205</p>
---	--	---	------------------------	---	--	---	--	--