
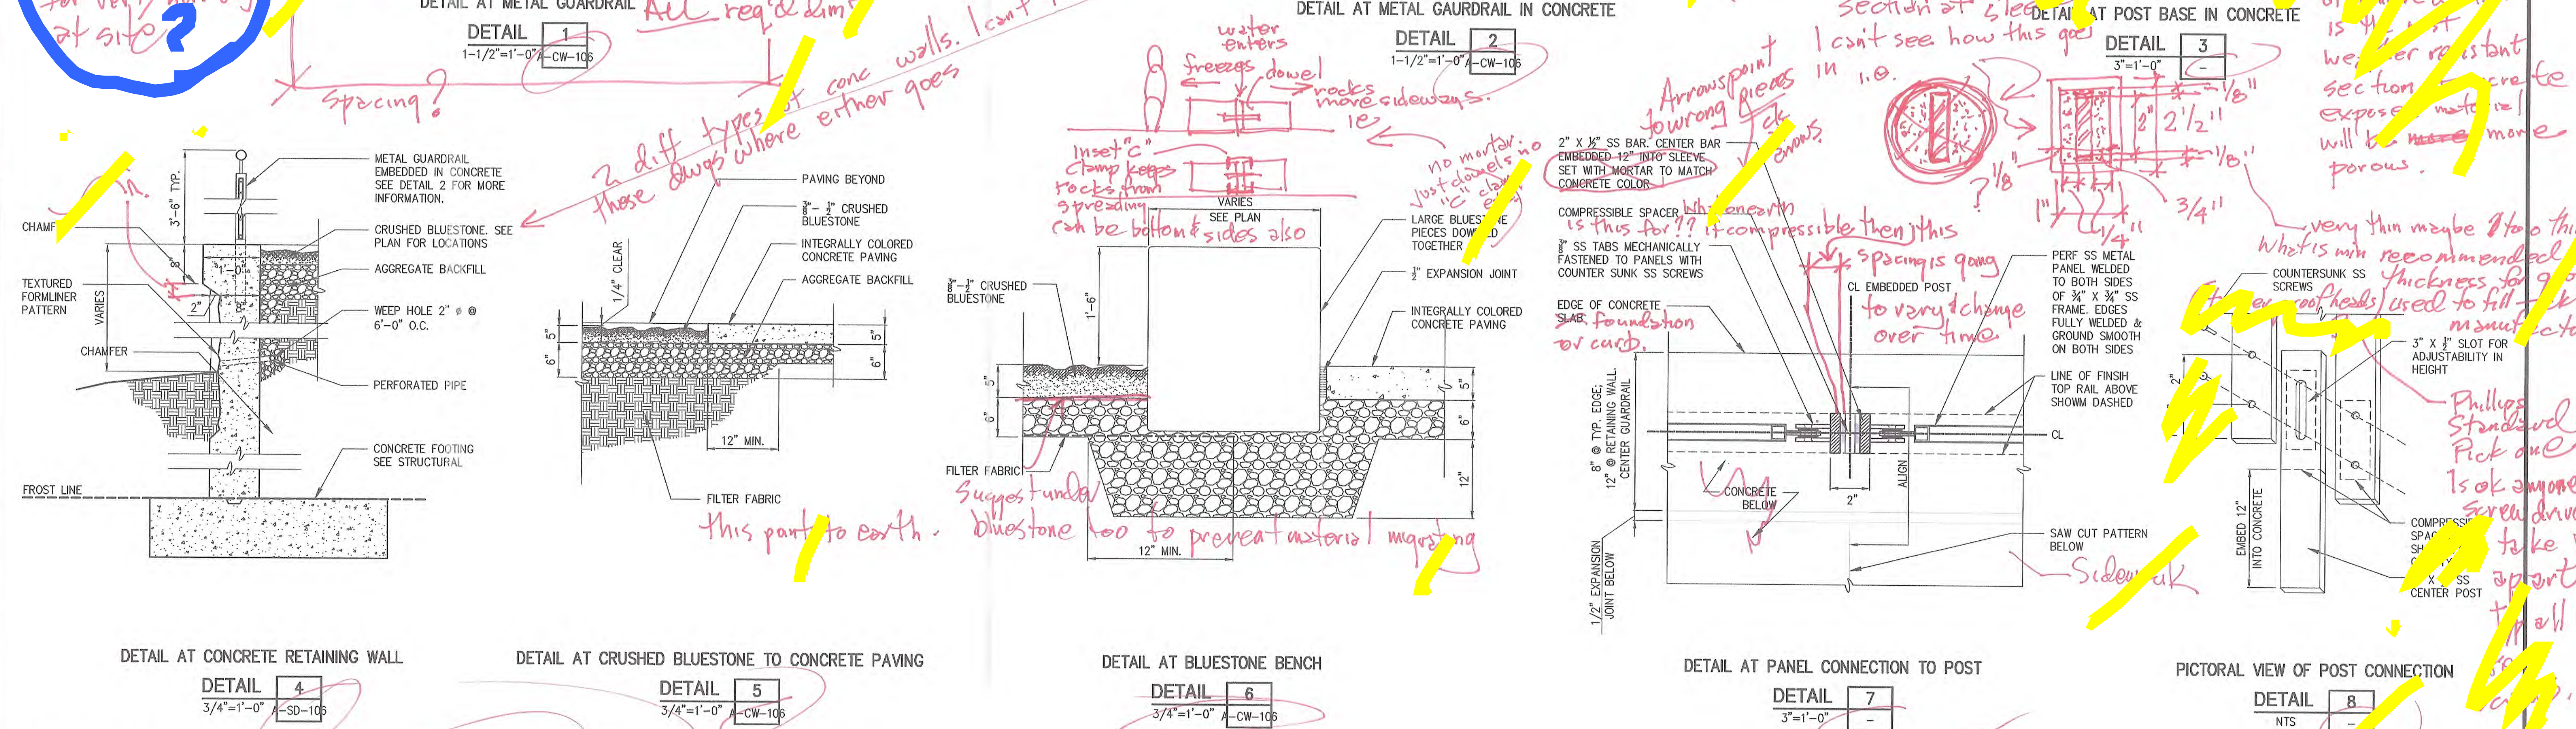


what this what are dimensions? what is this distance? maybe its not critical but it's not like this...

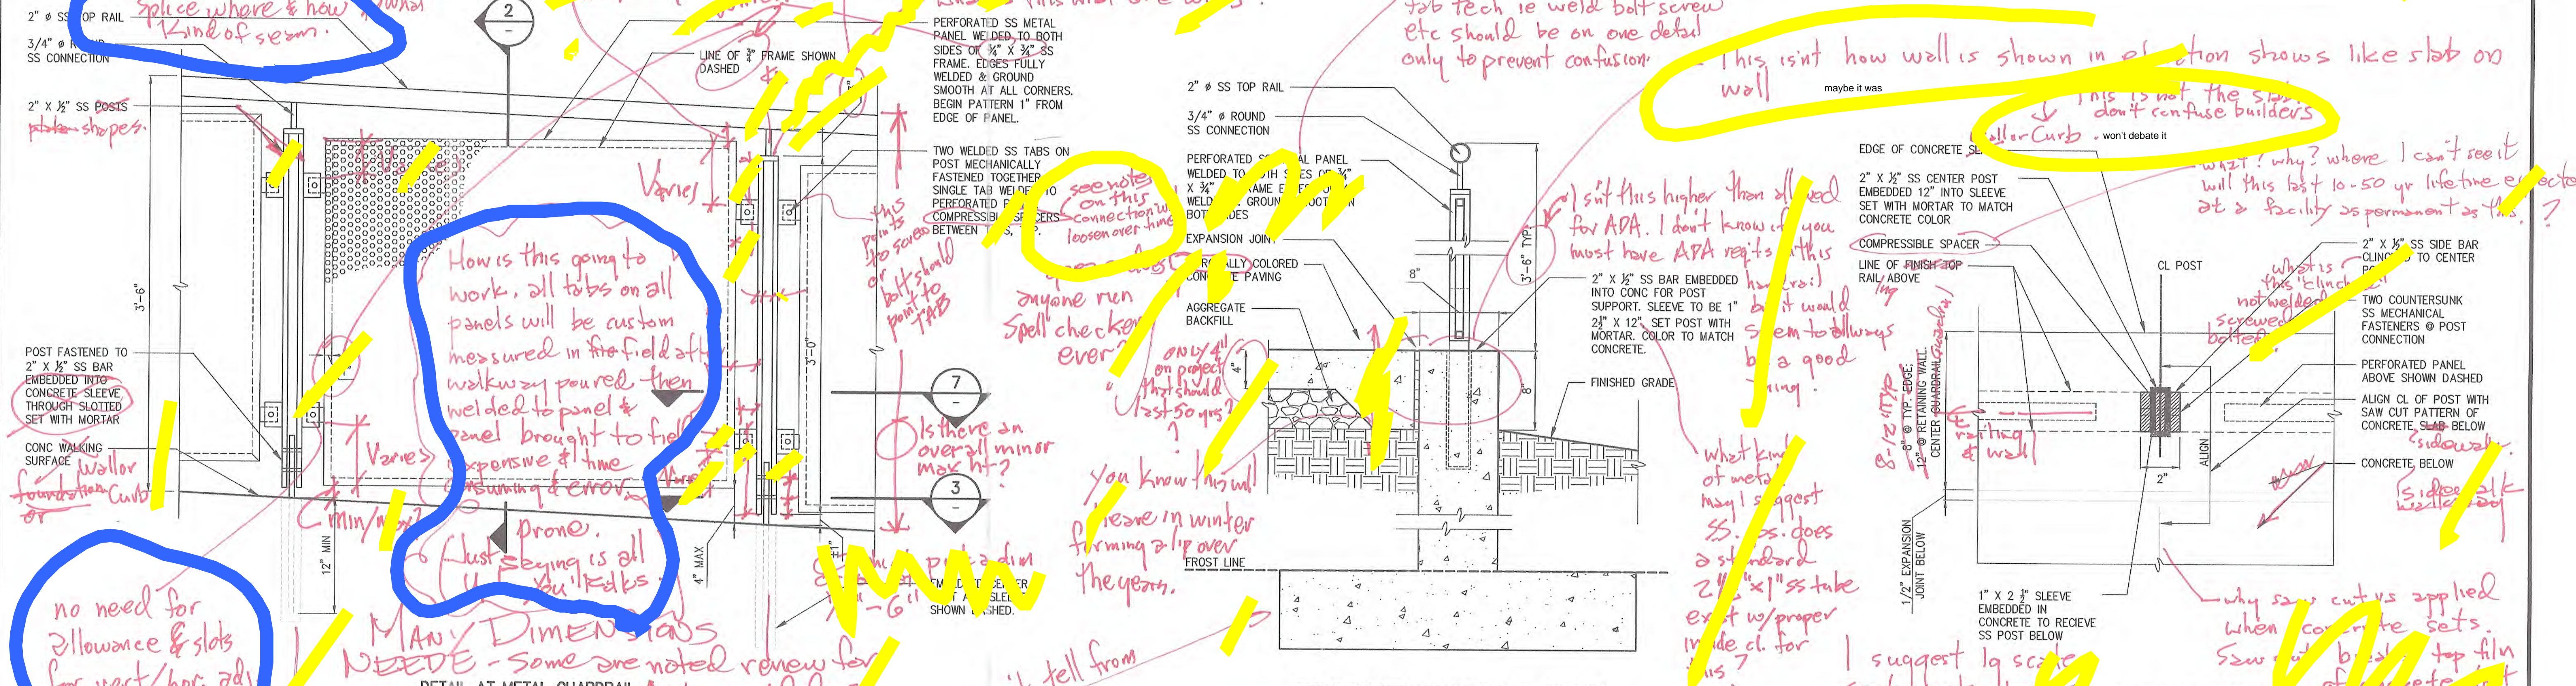

GoshowArchitects
 44 West 28th Street, 5 F / New York, NY 10001
 P 212.242.3735 / F 212.242.7460

Gannett Fleming
Hazen and Sawyer A Joint Venture
 468 Seventh Avenue - New York, NY 10018
 212.777-8400 - Fax: 212.611-4049

APPROVED FOR THE CITY OF NEW YORK
 EXECUTIVE PROJECT MANAGER
 CHIEF, UPSTATE WATER SUPPLY TREATMENT & FACILITIES DIVISION

CITY OF NEW YORK
 DEPARTMENT OF ENVIRONMENTAL PROTECTION
 BUREAU OF ENGINEERING DESIGN & CONSTRUCTION
 WM-30 WATERSHED IMPROVEMENTS
 RECONSTRUCTION OF
 CATSKILL WATERSHED DAMS AND ASSOCIATED FACILITIES

GILBOA DAM AND ASSOCIATED FACILITIES RECONSTRUCTION
 CONTRACT CAT-212B
 ARCHITECTURAL
 DAM RECONSTRUCTION
 DETAILS - SHEET 3 OF 5

90% SUBMITTAL
 DATE: AUGUST 2009
 SHEET NO: A19 OF
 DWG NO: A-SD-103

GENERAL CONSTRUCTION NOTE:
 SEE CIVIL AND STRUCTURAL
 DRAWINGS FOR COMPLETE SCOPE
 OF WORK

DESIGNED: KT
 DRAWN: LAE
 CHECKED: MR
 SECT. CHIEF: FEG
 PROJ. ENGR.: JC

SCALE: AS SHOWN

WARNING:
 IT IS A VIOLATION OF SECTION 2209.2 OF THE NEW YORK STATE EDUCATION LAW FOR ANY PERSON, UNLESS ACTING UNDER THE DIRECTION OF A LICENSED PROFESSIONAL ENGINEER, TO ALTER IN ANY WAY PLANS, SPECIFICATIONS, PLANS OR REPORTS TO WHICH THE SEAL OF A PROFESSIONAL ENGINEER HAS BEEN AFFIXED IF AN ITEM BEARING THE SEAL OF A PROFESSIONAL ENGINEER IS ALTERED, THE ALTERING ENGINEER SHALL AFFIX TO THE ITEM HIS SEAL AND THE NOTATION "ALTERED BY" FOLLOWED BY HIS SIGNATURE, THE DATE, AND A SPECIFIC DESCRIPTION OF THE ALTERATION.