


EAST OVERLOOK (PUBLIC) WALKWAY AREA PARTIAL PLAN

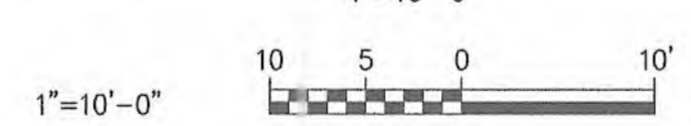

Who is "doing" a retaining wall under edge of porch? walk edge of porch? walk edge of porch?
 You need to locate these two objects in space from a start point. Also need to dimension entire pit area. Suggest large scale start plan.

More spot elevations in conjunction with slope rise/run for slopes on walkways. Add to plan.

Is this enough dimensioning to tie in entire project to this one control point?

Relocate note Callout detail No.

Paving & footings for wall. Should they be sized & constructed for future crane loading (cranes & leveling pads) or will they just replace it all if it cracks?

Removable or fixed section? If removable make section in front removable.

Does walkway footing or edge beam when no foundation below?

This gravel area might be a maintenance problem for facility. Maybe ask if they want it gravelled?

SIDEWALK SLOPES: confirm slope of sidewalks & ramps. ADA & other code req. It looks like you got btw the metal deck & interpretive center.

DRainage: see notes on drawing above. 1/4" x 1/4" x 1/4" = 120 sq ft. 1/4" x 1/4" x 1/4" = 500 gal, you can easily get 2 1/4" x 1/4" x 1/4" for 500 gal. This is a waste shed for it's lots of rain.

All paving, sidewalk, & metal walkway elevations slope rise/run of slopes, spot elevations.

Run spill GR. If I can spot a spelling error there must be more. Run on all days.

- NOTES:
- SEE A-CW-106 FOR PAVING PATTERNS AND SURFACE MATERIAL INFORMATION.
 - FOR EAST OVERLOOK INFORMATION REFER TO S-CG-135 AND S-CG-136 (LANDSCAPE DESIGNATIONS).
 - ALL SLOPES SHOWN ARE FOR REFERENCE ONLY. REFER TO LANDSCAPE'S PLANS FOR NEW GRADING AND FINISHING INFORMATION.
 - COORDINATE WORK FOR EAST GALLERY ACCESS STAIR STRUCTURE WITH ARCHITECTURAL SCOPE. SEE S-CG-143 AND 144 FOR MORE DETAILS.
 - CONTRACTOR SHALL SUBMIT LAYOUT PROPOSALS FOR ALL BLUESTONE WORK TOGETHER WITH PHOTOGRAPHS OF STONE FOR ARCHITECTS APPROVAL.
 - a) LABEL PHOTOGRAPHS TO BE CROSS REFERENCED WITH SUBMITTED LAYOUTS. COLOR, QUALITY, AND SIZE SHALL BE EVALUATED.

PATTERN LEGEND

SYMBOL	DESCRIPTION
[Grid Pattern]	SALVAGED BLUESTONE (NEW CONSTRUCTION)
[Cross-hatch Pattern]	CMU WALL W/ BLUESTONE COPING
[Stippled Pattern]	INTEGRALLY COLORED CONCRETE WALKING SURFACE

GoshowArchitects
 44 West 28th Street, 5 Fl / New York, NY 10001
 P 212.242.3735 / F 212.242.7460

abb Abel Bainson Butz, LLP
 Landscape Architects | Site Planners

GENERAL CONSTRUCTION NOTE:
 SEE CIVIL AND STRUCTURAL DRAWINGS FOR COMPLETE SCOPE OF WORK

Gannett Fleming
Hazen and Sawyer
 A Joint Venture
 498 Seventh Avenue - New York, NY 10018
 212 777-6400 - Fax: 212 614-9848

APPROVED FOR THE CITY OF NEW YORK
 EXECUTIVE PROJECT MANAGER
 P.E.
 CHIEF, UPSTATE WATER SUPPLY TREATMENT & FACILITIES DIVISION



CITY OF NEW YORK
 DEPARTMENT OF ENVIRONMENTAL PROTECTION
 BUREAU OF ENGINEERING DESIGN & CONSTRUCTION
 WM-30 WATERSHED IMPROVEMENTS
 RECONSTRUCTION OF
 CATSKILL WATERSHED DAMS AND ASSOCIATED FACILITIES

GILBOA DAM AND ASSOCIATED FACILITIES RECONSTRUCTION
 CONTRACT CAT-212B
 ARCHITECTURAL

EAST OVERLOOK PARTIAL PLAN - SHEET 1 OF 2

90% SUBMITTAL
 DATE: AUGUST 2009
 SHEET NO: A2 OF
 DWG NO: A-CW-102

NO.	DATE	ISSUED FOR	BY

WARNING
 IT IS A VIOLATION OF SECTION 2209.2 OF THE NEW YORK STATE EDUCATION LAW FOR ANY PERSON, UNLESS ACTING UNDER THE DIRECTION OF A LICENSED PROFESSIONAL ENGINEER, TO ALTER IN ANY WAY PLANS, SPECIFICATIONS, PLANS OR REPORTS TO WHICH THE SEAL OF A PROFESSIONAL ENGINEER HAS BEEN APPLIED, IF AN ITEM BEARING THE SEAL OF A PROFESSIONAL ENGINEER IS ALTERED, THE ALTERING ENGINEER SHALL AFFIX TO THE ITEM HIS SEAL AND THE NOTATION "ALTERED BY" FOLLOWED BY HIS SIGNATURE, THE DATE, AND A SPECIFIC DESCRIPTION OF THE ALTERATION.

DESIGNED: KT
 DRAWN: MW
 CHECKED: MR
 SECT. CHIEF: FEG
 PROJ. ENGR.: JC

SCALE: AS SHOWN

DESIGNED BY: KT
 DRAWN BY: MW
 CHECKED BY: MR
 SECT. CHIEF: FEG
 PROJ. ENGR.: JC