



XREFs= AX-SP-51-1130, LB-SP-ST, CAT211-BORDER, AN-SP-ST  
 IMAGEs= ABB-Acad-Logo.

NO.	DATE	ISSUED FOR	BY	DESIGNED	SCALE	AS SHOWN	P.E.	APPROVED FOR THE CITY OF NEW YORK	EXECUTIVE PROJECT MANAGER	P.E.	DEPARTMENT OF ENVIRONMENTAL PROTECTION	BUREAU OF ENGINEERING DESIGN & CONSTRUCTION	RECONSTRUCTION OF	GILBOA DAM AND ASSOCIATED FACILITIES RECONSTRUCTION	CONTRACT CAT-212B	ARCHITECTURAL	EAST OVERLOOK PAVING PLAN	DATE	AUGUST 2009	SHEET NO.	A6	OF		DWG NO.	A-CW-106
-----	------	------------	----	----------	-------	----------	------	-----------------------------------	---------------------------	------	--	---	-------------------	---	-------------------	---------------	---------------------------	------	-------------	-----------	----	----	--	---------	----------

**GoshowArchitects**  
 44 West 23rd Street, 5th Fl, New York, NY 10011  
 P: 212.253.2351 / F: 212.252.1460

**Abel Robinson Buttz, LLP**  
 Landscape Architectural Site Planners

GENERAL CONSTRUCTION NOTE:  
 SEE CIVIL AND STRUCTURAL  
 DRAWINGS FOR COMPLETE SCOPE  
 OF WORK

**Gannett Fleming**  
**Hazen and Sawyer**  
 488 Seventh Avenue, New York, NY 10018  
 212.777.4400 Fax: 212.814.3049


CHIEF, URS STATE WATER SUPPLY TREATMENT  
 & FACILITIES DIVISION



CITY OF NEW YORK  
 DEPARTMENT OF ENVIRONMENTAL PROTECTION  
 BUREAU OF ENGINEERING DESIGN & CONSTRUCTION  
 WM-30 WATERSHED IMPROVEMENTS  
 RECONSTRUCTION OF  
 CATSKILL WATERSHED DAMS AND ASSOCIATED FACILITIES

90% SUBMITTAL

DATE: AUGUST 2009  
 SHEET NO.: A6 OF  
 DWG NO.: A-CW-106

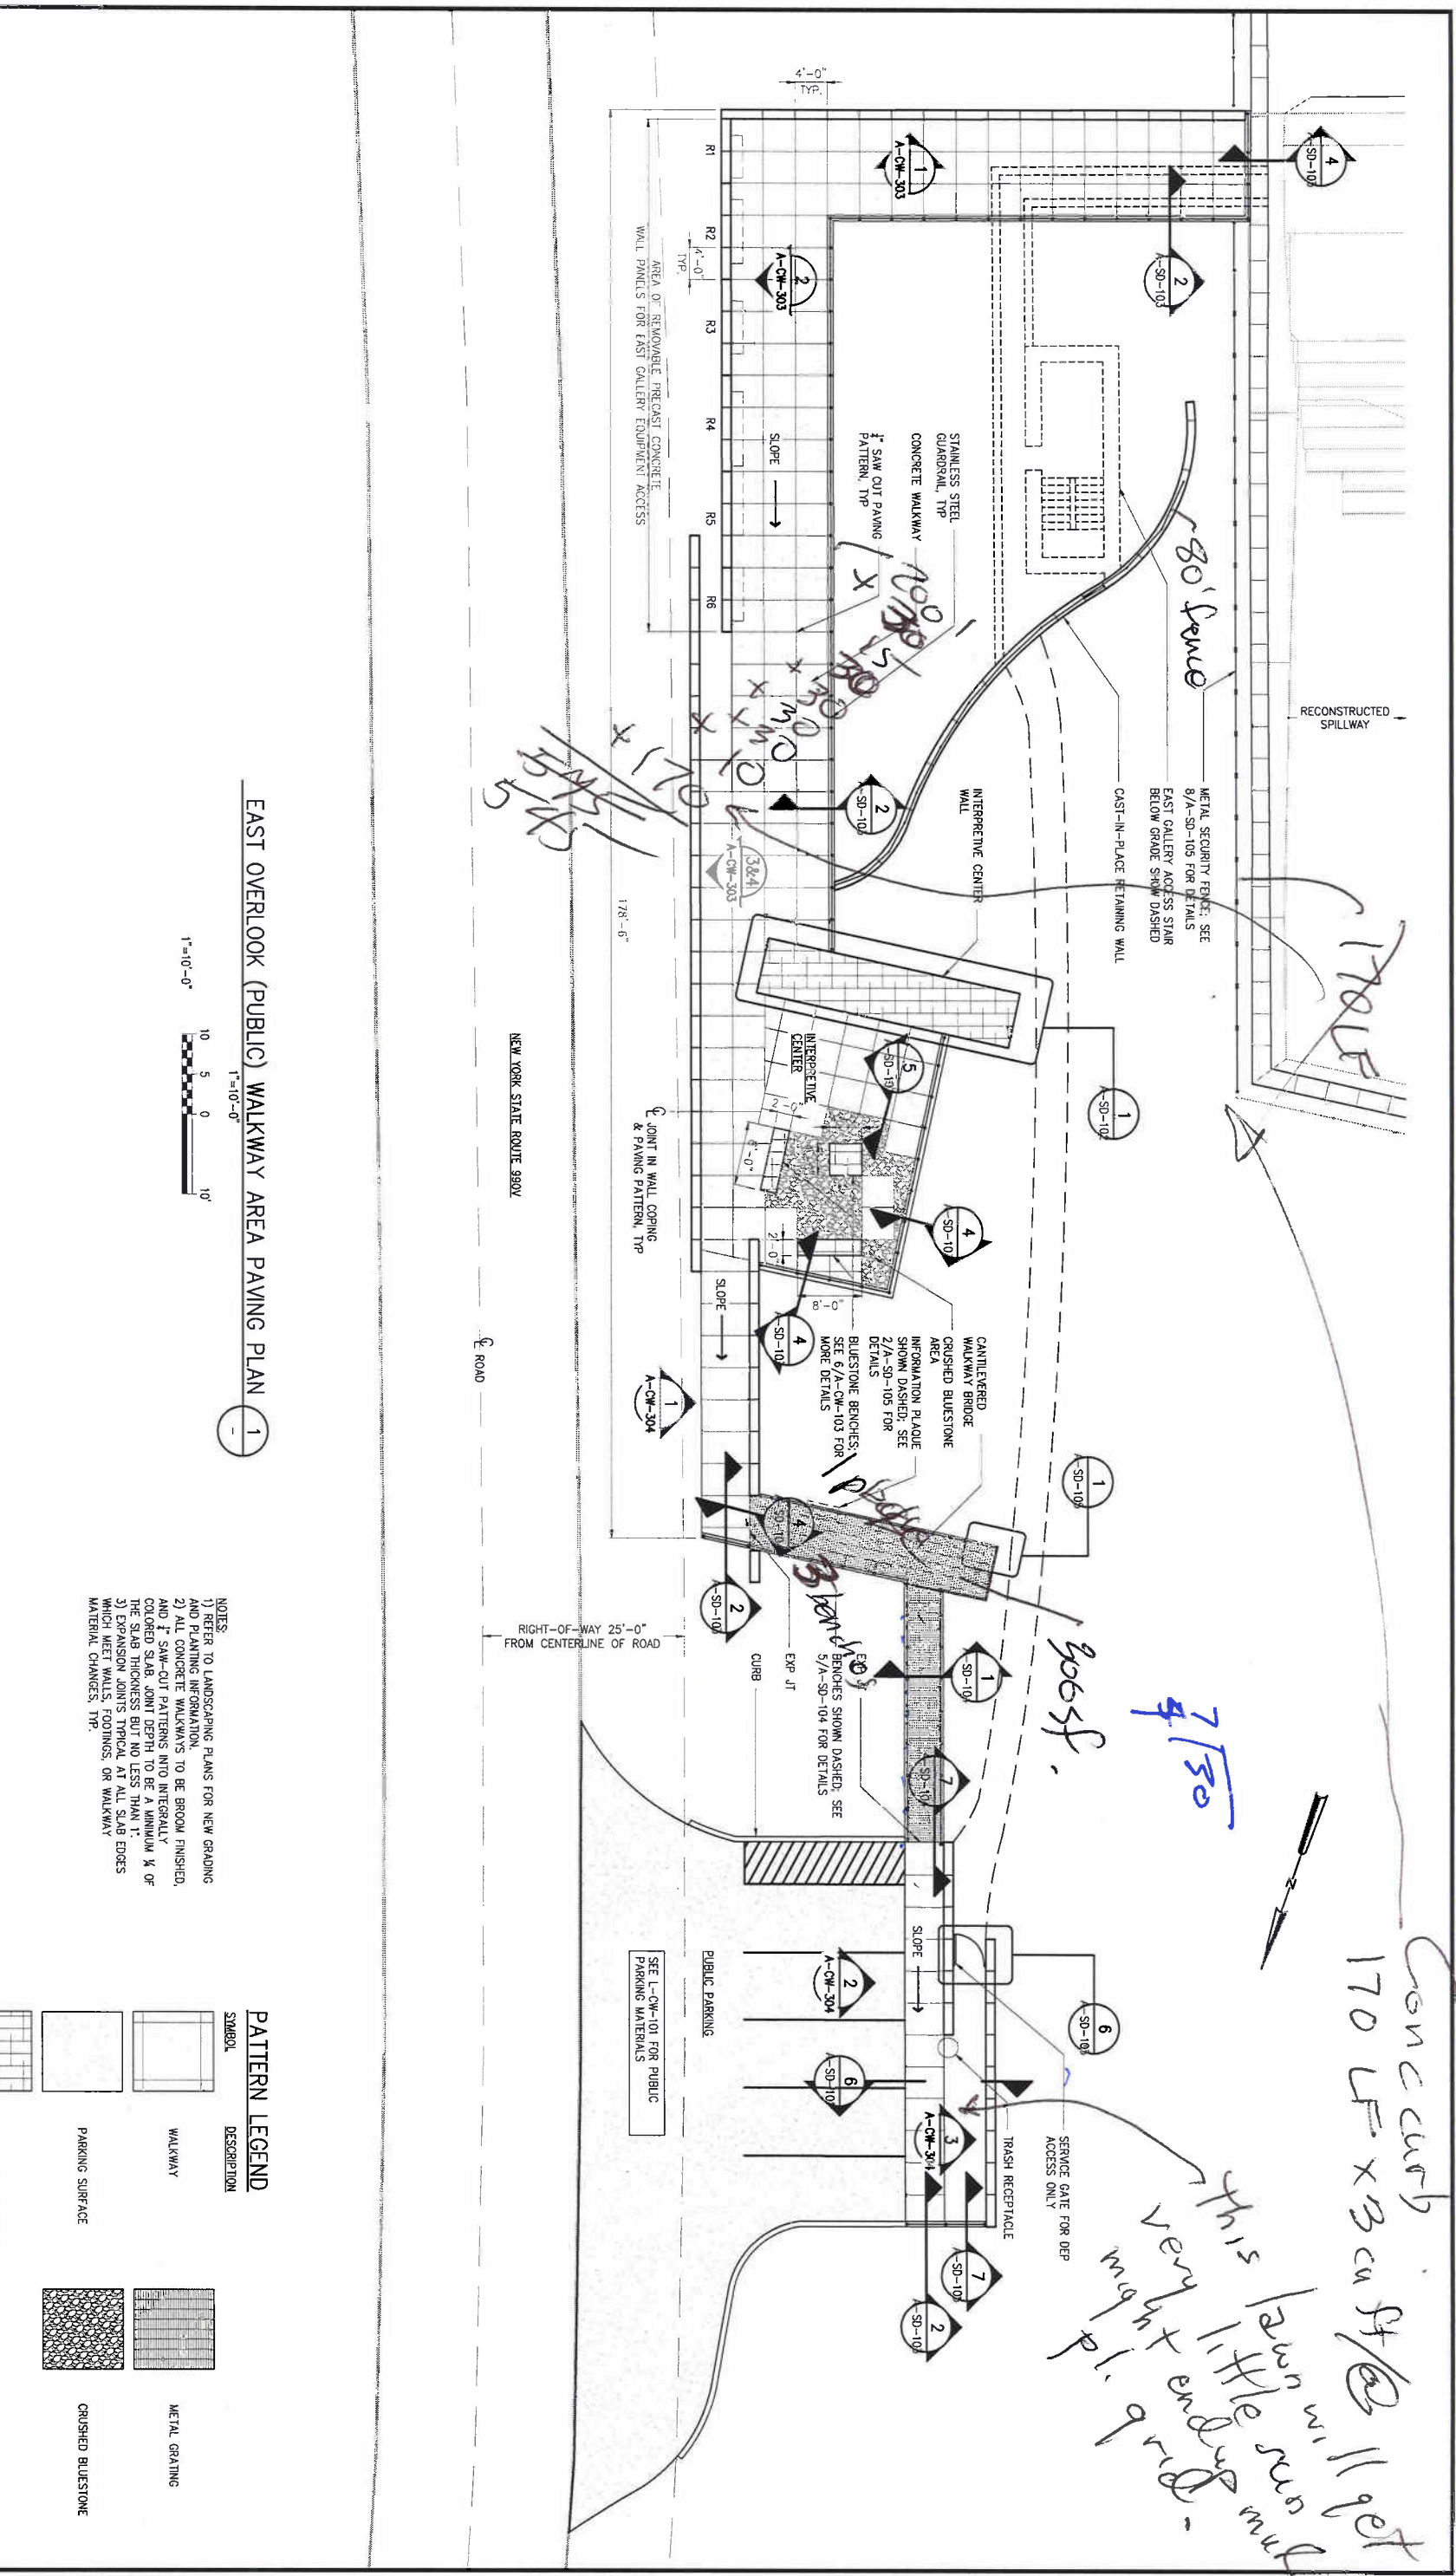

EAST OVERLOOK (PUBLIC) WALKWAY AREA PAVING PLAN 1



- NOTES:
- 1) REFER TO LANDSCAPING PLANS FOR NEW GRADING AND PLANTING INFORMATION.
  - 2) ALL CONCRETE WALKWAYS TO BE BROOM FINISHED, AND 1\"/>

**PATTERN LEGEND**

SYMBOL	DESCRIPTION
	WALKWAY
	PARKING SURFACE
	CRUSHED BLUESTONE (NEW CONSTRUCTION)
	METAL GRATING
	CRUSHED BLUESTONE

*Handwritten notes:*  
 Conc curb 170 LF x 3 cu ft @ 116 lb  
 This is from min fillers and  
 very light ends and  
 pl. of

